



MIAMI-DADE COUNTY
 DEPARTMENT OF PERMITTING, ENVIRONMENT, AND REGULATORY
 AFFAIRS (PERA)
 BOARD AND CODE ADMINISTRATION DIVISION

MIAMI-DADE COUNTY
PRODUCT CONTROL SECTION
 11805 SW 26 Street, Room 208
 Miami, Florida 33175-2474
 T (786) 315-2590 F (786) 315-2599

NOTICE OF ACCEPTANCE (NOA)

www.miamidade.gov/pera/

PGT Industries
1070 Technology Drive
North Venice, FL 34275

SCOPE:

This NOA is being issued under the applicable rules and regulations governing the use of construction materials. The documentation submitted has been reviewed and accepted by Miami-Dade County PERA - Product Control Section to be used in Miami Dade County and other areas where allowed by the Authority Having Jurisdiction (AHJ).

This NOA shall not be valid after the expiration date stated below. The Miami-Dade County Product Control Section (In Miami Dade County) and/or the AHJ (in areas other than Miami Dade County) reserve the right to have this product or material tested for quality assurance purposes. If this product or material fails to perform in the accepted manner, the manufacturer will incur the expense of such testing and the AHJ may immediately revoke, modify, or suspend the use of such product or material within their jurisdiction. PERA reserves the right to revoke this acceptance, if it is determined by Miami-Dade County Product Control Section that this product or material fails to meet the requirements of the applicable building code.

This product is approved as described herein, and has been designed to comply with the Florida Building Code, including the High Velocity Hurricane Zone.

DESCRIPTION: Series "SH-3000" Aluminum Single Hung Window - S.M.I.

APPROVAL DOCUMENT: Drawing No. 3000A-7-07, titled "Alum. Single Hung Window, Imp. (SM)", sheets 1 through 11 of 11, dated 07/12/07 with revision B dated 10/10/11, prepared by manufacturer, signed and sealed by Anthony Lynn Miller, P.E., bearing the Miami-Dade County Product Control Revision stamp with the Notice of Acceptance number and expiration date by the Miami-Dade County Product Control Section.

MISSILE IMPACT RATING: Small Missile Impact Resistant

LABELING: Each unit shall bear a permanent label with the manufacturer's name or logo, city, state, model/series, and following statement: "Miami-Dade County Product Control Approved", unless otherwise noted herein.

RENEWAL of this NOA shall be considered after a renewal application has been filed and there has been no change in the applicable building code negatively affecting the performance of this product.

TERMINATION of this NOA will occur after the expiration date or if there has been a revision or change in the materials, use, and/or manufacture of the product or process. Misuse of this NOA as an endorsement of any product, for sales, advertising or any other purposes shall automatically terminate this NOA. Failure to comply with any section of this NOA shall be cause for termination and removal of NOA.

ADVERTISEMENT: The NOA number preceded by the words Miami-Dade County, Florida, and followed by the expiration date may be displayed in advertising literature. If any portion of the NOA is displayed, then it shall be done in its entirety.

INSPECTION: A copy of this entire NOA shall be provided to the user by the manufacturer or its distributors and shall be available for inspection at the job site at the request of the Building Official.

This NOA revises NOA # 07-0905.03 and consists of this page 1 and evidence pages E-1 and E-2, as well as approval document mentioned above.

The submitted documentation was reviewed by **Manuel Perez, P.E.**



NOA No. 11-1013.17
 Expiration Date: December 06, 2012
 Approval Date: December 08, 2011
 Page 1

NOTICE OF ACCEPTANCE: EVIDENCE SUBMITTED

A. DRAWINGS

1. Manufacturer's die drawings and sections.
2. Drawing No. **3000A-7-07**, titled "Alum. Single Hung Window, Imp. (SM)", sheets 1 through 11 of 11, dated 07/12/07 with revision **B** dated 10/10/11, prepared by manufacturer, signed and sealed by Anthony Lynn Miller, P.E.

B. TESTS

1. Test reports on:
 - 1) Air Infiltration Test, per FBC, TAS 202-94
 - 2) Uniform Static Air Pressure Test, Loading per FBC TAS 202-94
 - 3) Water Resistance Test, per FBC, TAS 202-94
 - 4) Large Missile Impact Test per FBC, TAS 201-94
 - 5) Cyclic Wind Pressure Loading per FBC, TAS 203-94
 - 6) Forced Entry Test, per FBC 2411 3.2.1, TAS 202-94along with marked-up drawings and installation diagram of a series SH-3000 aluminum single hung window, prepared by Fenestration Testing Laboratory, Inc., Test Report No. **ATIFL-72154.01-401-18**, dated 08/21/07, signed and sealed by Gilbert Diamond, P.E.
(Submitted under previous NOA #07-0905.03)

C. CALCULATIONS


1. Anchor verification calculations and structural analysis, complying with FBC-2007 and FBC-2010, dated 11/02/07 and updated on 10/07/11, signed and sealed by Anthony Lynn Miller, P.E.
2. Glazing complies with ASTM E1300-04

D. QUALITY ASSURANCE

1. Miami-Dade Department of Permitting, Environment, and Regulatory Affairs (PERA).

E. MATERIAL CERTIFICATIONS

1. Notice of Acceptance No. **10-0922.09** issued to **E.I. DuPont DeNemours & Co., Inc.** for their "**DuPont Butacite® PVB, Interlayer**" dated 12/24/10, expiring on 12/11/11.


Manuel Pérez, P.E.
Product Control Examiner
NOA No. 11-1013.17
Expiration Date: December 06, 2012
Approval Date: December 08, 2011

PGT Industries


NOTICE OF ACCEPTANCE: EVIDENCE SUBMITTED

F. STATEMENTS

1. Statement letter of conformance to the FBC-2007 and FBC-2010, dated 10/07/11, signed and sealed by Anthony Lynn Miller, P.E.
2. Statement letter of no financial interest, dated 10/07/11, signed and sealed by Anthony Lynn Miller, P.E.
3. Laboratory compliance letter for Test Report no. **ATIFL 72154.01-401-18** issued by Architectural Testing, Inc., dated 08/21/07, signed and sealed by Joseph A. Reed, P.E. *(Submitted under NOA# 07-0905.03)*

G. OTHER

1. Notice of Acceptance No. **07-0905.03**, issued to PGT Industries for their Series "SH-3000" Aluminum Single Hung Window - S.M.I., approved on 12/06/07 and expiring on 12/06/12.

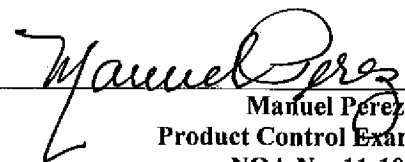
Manuel Perez, P.E.
Product Control Examiner
NOA No. 11-1013.17

Expiration Date: December 06, 2012

Approval Date: December 08, 2011

GENERAL NOTES: SMALL MISSILE IMPACT SINGLE HUNG WINDOW



1. GLAZING OPTIONS:
7/16" LAMINATED GLASS CONSISTING OF (2) LITES OF 3/16" TEMPERED GLASS WITH AN .060 PVB INTERLAYER OF DUPONT BUTACITE.
2. CONFIGURATIONS: "OX" (1/1, ORIEL), TOP SASH REMOVABLE.
3. DESIGN PRESSURES: (SEE TABLE 1)
 - A. NEGATIVE DESIGN LOADS BASED ON TESTED PRESSURE AND GLASS TABLES ASTM E 1300-02.
 - B. POSITIVE DESIGN LOADS BASED ON WATER AND STRUCTURAL TEST PRESSURE AND GLASS TABLES ASTM E 1300-02.
4. ANCHORAGE: THE 33 1/3% STRESS INCREASE HAS NOT BEEN USED IN THE DESIGN OF THIS PRODUCT. SEE SHEETS 6 THROUGH 10 FOR ANCHORAGE DETAILS.
5. SHUTTER REQUIREMENT: ABOVE 30 FT. SHUTTERS ARE NOT REQUIRED.
6. FRAME AND PANEL CORNERS SEALED WITH NARROW JOINT SEALANT OR GASKET.
7. REFERENCES: TEST REPORTS (ATI) 72132-.01-401-18
ELCO TEXTRON NOA: 04-0721.01
ANSI/AF&PA NDS-2001 FOR WOOD CONSTRUCTION
ADM-2005 ALUMINUM DESIGN MANUAL
8. THIS PRODUCT HAS BEEN DESIGNED & TESTED TO COMPLY WITH THE REQUIREMENTS OF THE FLORIDA BUILDING CODE, INCLUDING THE HIGH VELOCITY HURRICANE ZONE (HVHZ).
9. FOR CONCRETE OR CONCRETE BLOCK APPLICATIONS IN MIAMI-DADE COUNTY, USE ONLY MIAMI-DADE COUNTY APPROVED 5/16" ELCO TAPCONS. MINIMUM DISTANCE FROM ANCHOR TO CONCRETE EDGE IS 1-9/16". ANCHORS SHOULD NOT BE INSTALLED WITHIN 5" OF EACH OTHER. FOR WOOD APPLICATIONS IN MIAMI-DADE COUNTY, USE #14 WOOD SCREWS. SCREW THREADS MUST BE COMPLETELY EMBEDDED INTO SUBSTRATE.

NOTE:
FOR SMALL MISSILE APPLICATIONS ONLY

DESIGN PRESSURE		
	POS	NEG
7/16" TEMPERED LAMI	+110.0	-165.0
DESIGN PRESSURE MAY BE LIMITED BASED ON ANCHOR TYPE USED. SEE ANCHORAGE TABLES 2, 3 AND 4 ON SHEETS 8, 9 AND 10.		

NOA DRAWING MAP

SHEET	
GENERAL NOTES.....	1
GLAZING DETAILS.....	1
DESIGN PRESSURES.....	1
ELEVATIONS.....	2-3
VERT. SECTIONS.....	3
HORIZ. SECTIONS.....	3
PARTS LIST.....	4
CORNER DETAIL.....	4
EXTRUSIONS.....	5
ANCHORAGE.....	6-7
ANCHOR QUANTITIES.....	8-10
EGRESS CHART.....	11

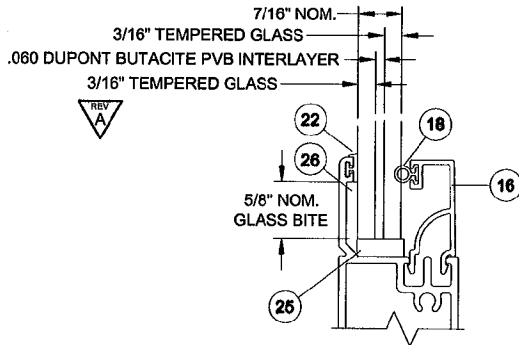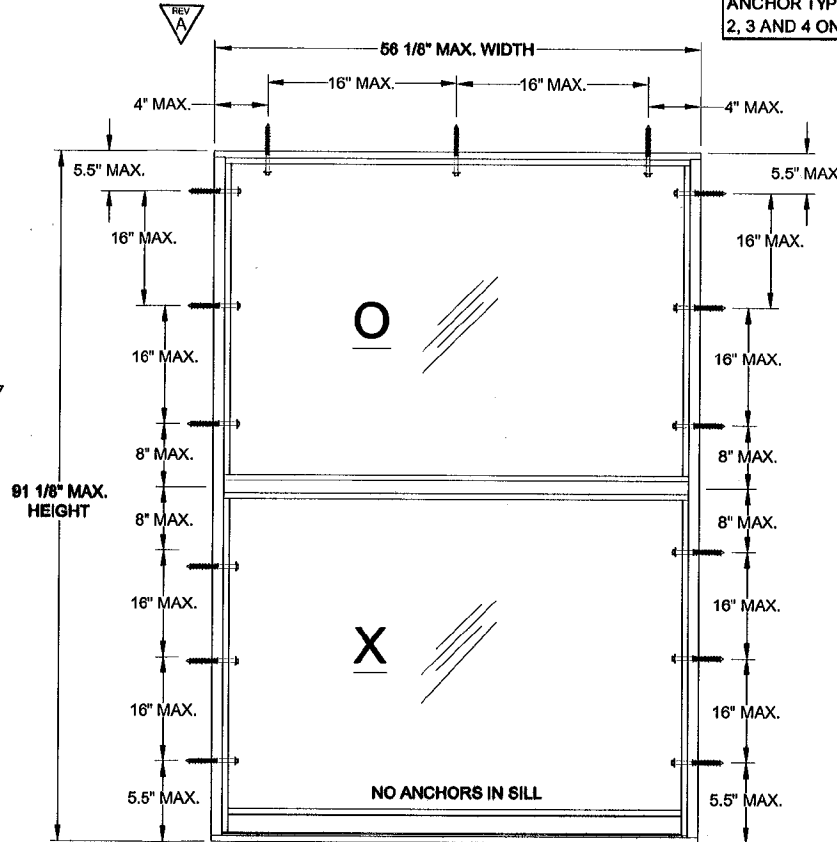


7/16" LAMI GLAZING DETAIL
(TYPICAL ACTIVE & FIXED SASH)

ABOVE ANCHORAGE DETAILS REFER TO MAXIMUM SPACING. FOR EXACT ANCHORAGE REQUIREMENTS, PLEASE SEE THE ENCLOSED SHEETS

DETAIL A

PRODUCT REVISED as complying with the Florida Building Code
Acceptance No. 11-1013.17
Expiration Date DEC. 6, 2012
By Manuel Perez
Miami Dade Product Control

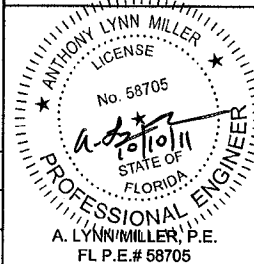

Revised By: J.R.	Date: 9/28/08	Revisions: A. Added Anchor Elevation, new notes for Miami-Dade, corrected Table 1, redraw glazing detail to fit page,
Revised By: J.J.	Date: 10/10/11	Revisions: B FBC 2010 CODE CHANGE
Drawn By: J.R.	Date: 07/12/07	Checked By: J.R. Date: 7/13/07

1070 TECHNOLOGY DRIVE
NOKOMIS, FL 34275
P.O. BOX 1626
NOKOMIS, FL 34274




Description: GENERAL NOTES, GLAZING DETAIL & DP
Title: ALUM. SINGLE HUNG WINDOW, IMP. (SM)
Series/Model: SH3000
Code: NTS
Sheet: 1 of 11
Drawing No: 3000A-7-07
Rev: B

NOTE:
FOR SMALL MISSILE APPLICATIONS ONLY

Daylight Opening Width = Window Width - 6.5
 Daylight Opening Height = Window Height - 5
 2

Above formulas are for both top and bottom sashes, and only for even split windows.


REV
A

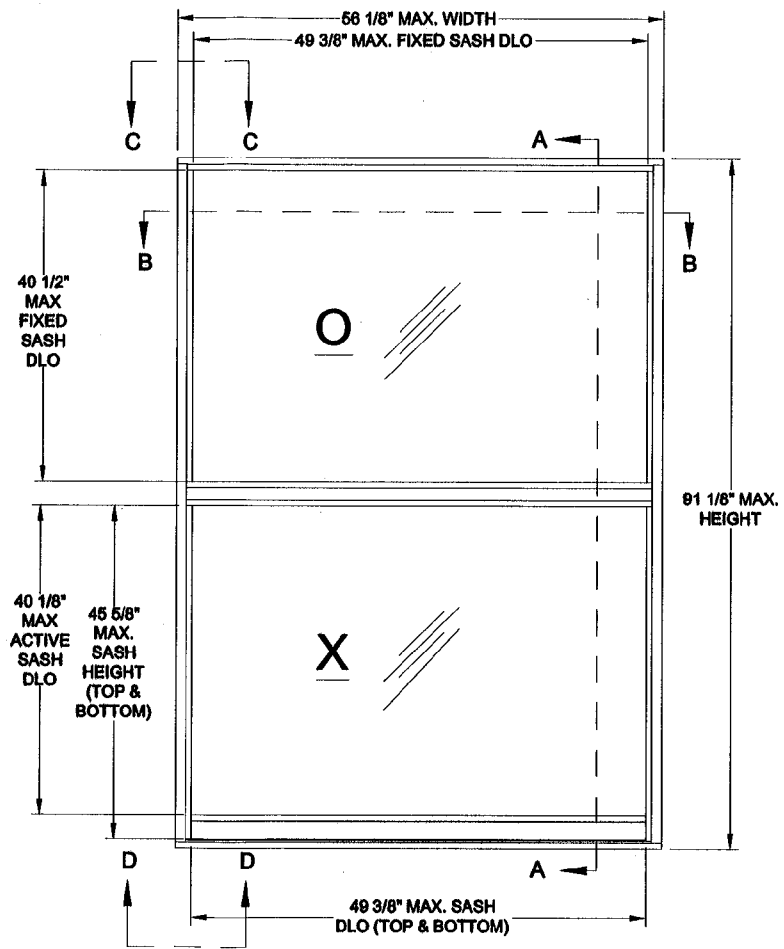

DETAIL A

- NOTES:**
1. SEE SHEET 3 FOR VERTICAL AND HORIZONTAL SECTION DETAILS.
 2. SEE SHEET 4 FOR CORNER DETAIL VIEWS AND BILL OF MATERIAL.
 3. SEE SHEETS 6 THROUGH 10 FOR ANCHORAGE INFORMATION.

PRODUCT REVISED as complying with the Florida Building Code
 Acceptance No. 11-1013.17
 Expiration Date DEC 6, 2012
 By *Manuel Saez*
 Miami Trade Product Control

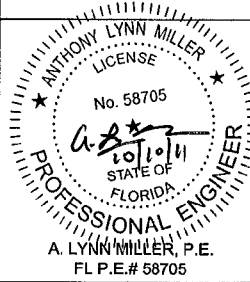

Revised By: J.R.	Date: 8/28/08	Revisions: A.	A. Added formula for daylite calculations
Revised By: J.J.	Date: 10/10/11	Revisions: B	NO CHANGE THIS SHEET
Revised By:	Date:	Revisions:	
Drawn By: J.R.	Date: 07/12/07	Checked By: J.R.	Date: 7/13/07

1070 TECHNOLOGY DRIVE
 NOKOMIS, FL 34276
 P.O. BOX 1629
 NOKOMIS, FL 34274








Description: ELEVATIONS	Series/Model: SH3000	Scale: NTS	Sheet: 2 of 11	Drawing No. 3000A-7-07	Rev: B
Title: ALUM. SINGLE HUNG WINDOW, IMP. (SM)					

NOTE:
FOR SMALL MISSILE
APPLICATIONS ONLY

**TYPICAL LOWER
CORNER DETAIL**

**TYPICAL UPPER
CORNER DETAIL**

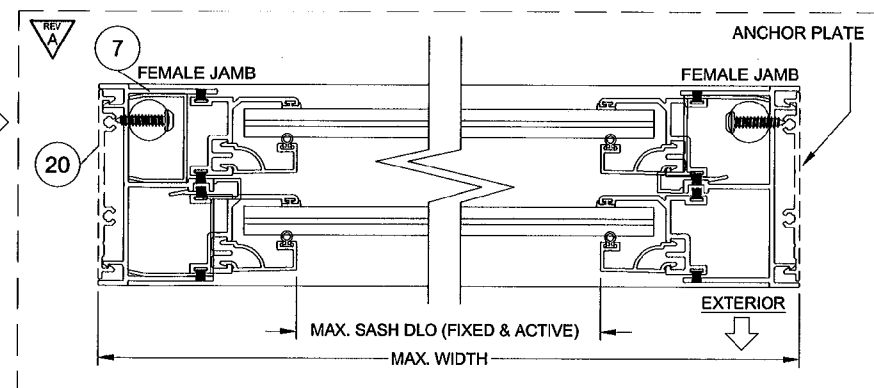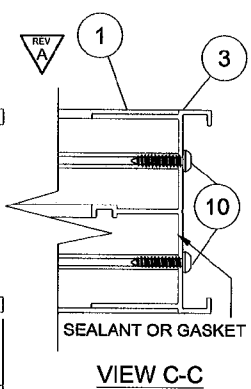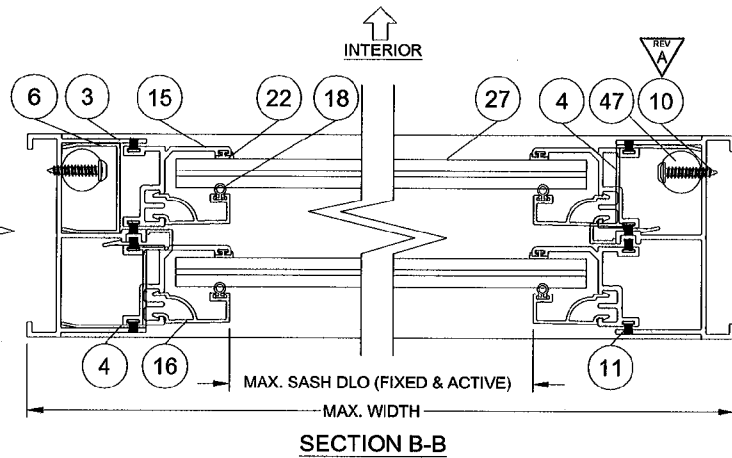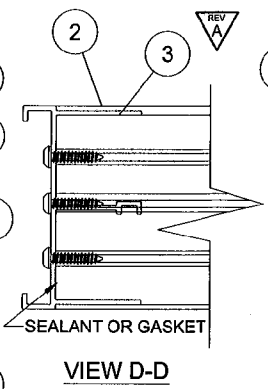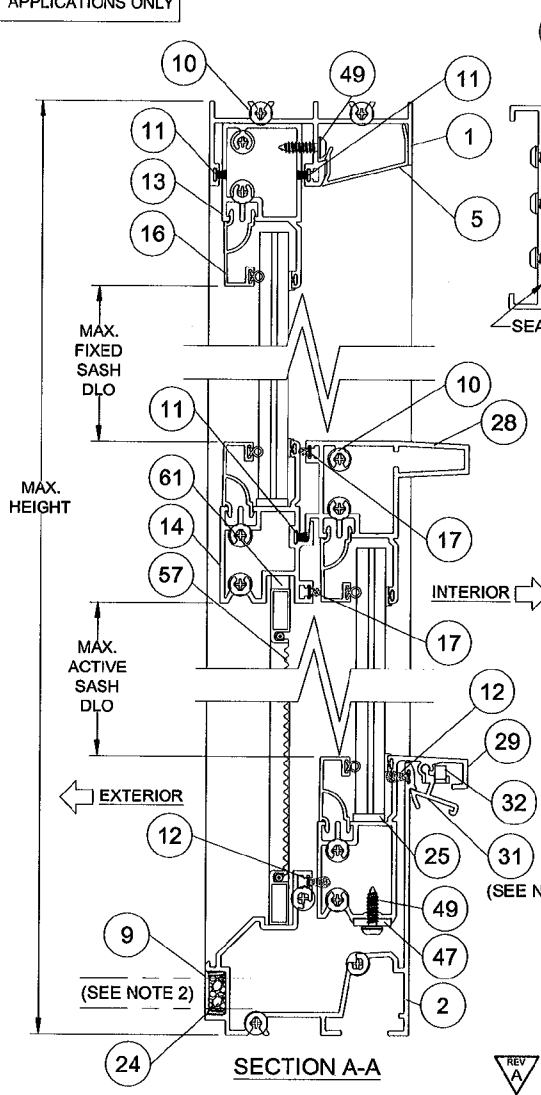


**ALT. SECTION B-B
OPTIONAL ANCHOR PLATE & FEMALE JAMB**

NOTES:

1. TWO BOTTOM LOCKS LOCATED 4" FROM EACH SIDE OF VENT.
2. THREE 1" X 5/8" WEEPHOLES REQUIRED, TWO AT 6.25" FROM END OF SILL, AND ONE AT MIDSPAN. TWO END WEEPHOLES MAY BE USED IF THE WINDOW IS 34" OR LESS IN WIDTH.
3. THE OPTIONAL ANCHOR PLATE IS TO BE USED WHEN SPECIFIED BY THE ANCHOR QUANTITY CHARTS OF PAGES 8-10.

PRODUCT REVISED
as complying with the Florida
Building Code
Acceptance No. 11-1013.17
Expiration Date DEC. 6, 2012
By *Mmanuel Ins*
Miami Dade Product Control

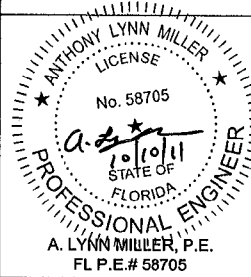

Revised By: J.R.	Date: 8/28/08	Revisions: A. New notes and drawing for Anchor plate, moved sections C-C and D-D from other page, corrected item 10
Revised By: J.J.	Date: 10/10/11	Revisions: B. NO CHANGE THIS SHEET
Drawn By: J.R.	Date: 07/12/07	Checked By: J.R. Date: 7/13/07

1070 TECHNOLOGY DRIVE
NOKOMIS, FL 34275
P.O. BOX 1529
NOKOMIS, FL 34274




SECTIONS			
Title: ALUM. SINGLE HUNG WINDOW, IMP. (SM)			
Series/Model: SH3000	Scale: 1/2	Sheet: 3 of 11	Drawing No.: 3000A-7-07
			Rev: B

REV A


TABLE 2.

#	Dwg #	Description
1	13002A	Frame Head (Equal Leg)
2	13040	Frame Sill (Equal Leg)
3	13004	Frame Jamb (Equal Leg)
4	13017	Jamb Trim Cover/Sash Stop
5	13044	Head Screw Cover
6	4053	Balance Cover
7	13116	Female Jamb
9	13139	Track Cover
10	13011	Frame/Sash Screws #10 x 1.25" PH
11	1059	Wstp .187 X .210 FS
12	1010A	Sill Wstp, 3/8" x .190 Foam Bulb
13	13005	Top Sash Top Rail
14	13043	Top Sash Bottom Rail
15	13007	Sash Side Rail
16	13012	Beading 7/16
17	1213	MR Wstp, .200" x .190 Foam Bulb
18	1224	Bead Wstp.
20	13103	Anchor Plate
21	13099	Interlock Clip
22	13020	Glazing Leg Wstp
24	1626	Baffle (Open Cell Foam 30 PPI)
25	1614	Setting Blocks .125 X .5 X 1.00
26	-	GE 7700 or Equiv.
27	-	Glass
28	13042	Bottom Sash Top Rail
29	13041	Bottom Sash Bottom Rail
31	13057	Bottom Lock
32	1088	Bottom Lock Spring
33	-	Sash Top Guide Post
34	-	#8 x 3/4 Ph PH SS
35	13077	Sash Top Guide (Left)
36	13076	Sash Top Guide (Right)
37	13144	Mounting Clip
40	13078	Sash Bottom Guide (Right)
41	13079	Sash Bottom Guide (Left)
42	4029	Balance Clip
43	13059	Top Lift Rail Cap (L & R)
44	13097	Bottom Lift Rail Cap (Right)
45	13098	Bottom Lift Rail Cap (Left)
46	13026	Cap Screws 10-32 x 1/2 Hex
47	4029-1	Caldwell Ultra-Lift Balance
49	-	#10 x 3/4 Ph PH SD SS
55	1279B	Extruded Screen Frame
57	61816	Screen Cloth
58	1239A	Top Corner Keys
59	1632	Bottom Corner Keys
60	1635	Screen Spline
61	1073	Screen Spring

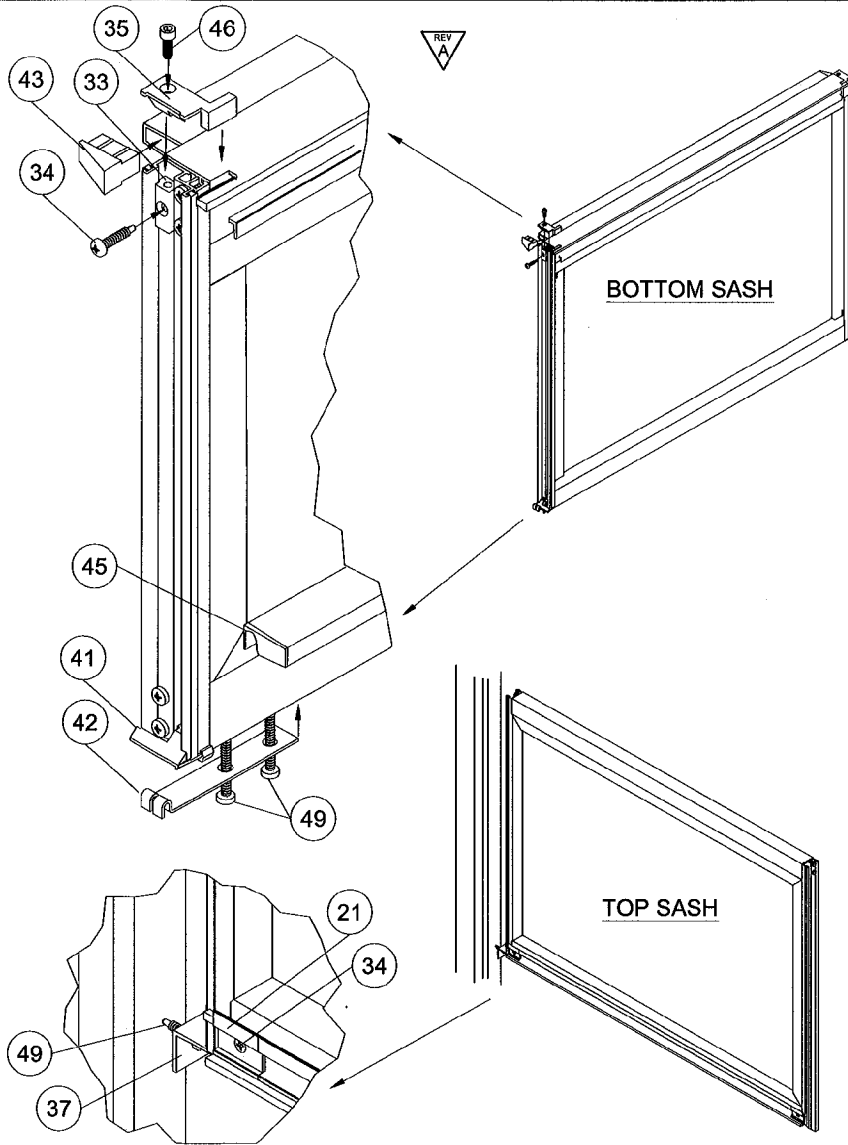

NOTE:
FOR SMALL MISSILE
APPLICATIONS ONLY

PRODUCT REVISED
as complying with the Florida
Building Code
Acceptance No. 11-1013.17
Expiration Date Dec. 6, 2012
By Mmanuel...
Miami/Dade Product Control

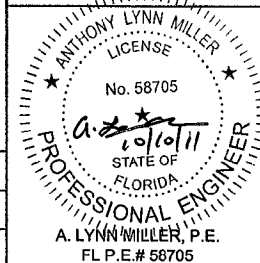

Revised By: J.R.	Date: 8/28/08	Revisions: A.	Corrected Table 2, added 3-D corner details
Revised By: J.J.	Date: 10/10/11	Revisions: B	NO CHANGE THIS SHEET
Revised By:	Date:	Revisions:	
Drawn By: J.R.	Date: 07/12/07	Checked By: J.R.	Date: 7/13/07


1070 TECHNOLOGY DRIVE
NOKOMIS, FL 34276

P.O. BOX 1629
NOKOMIS, FL 34274




Description:	PARTS LIST & FRAME CORNER DETAIL		
Title:	ALUM. SINGLE HUNG WINDOW, IMP. (SM)		
Series/Model:	Scale:	Sheet:	Drawing No.
SH3000	NTS	4 of 11	3000A-7-07
Rev:	B		


NOTE:
FOR SMALL MISSILE
APPLICATIONS ONLY

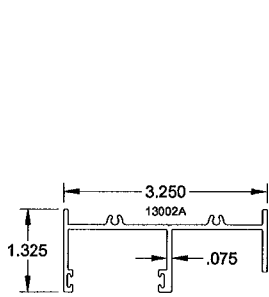


1 FRAME HEAD

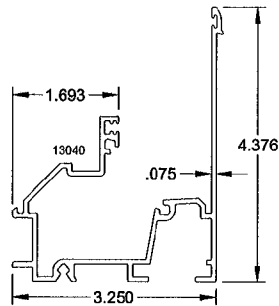

2 FRAME SILL

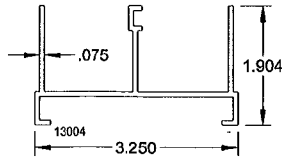


3 FRAME JAMB

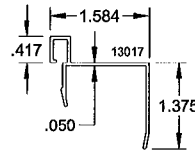


4 JAMB TRIM COVER/
SASH STOP




5 HEAD SCREW
COVER

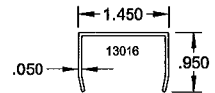


6 BALANCE COVER

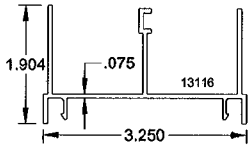


7 FEMALE JAMB

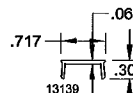


9 TRACK COVER

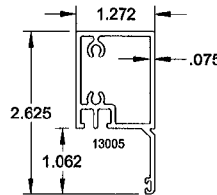


13 TOP SASH
TOP RAIL

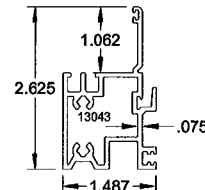


14 TOP SASH
BOTTOM RAIL

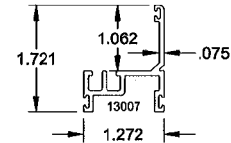


15 SASH SIDE RAIL

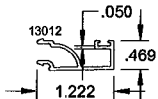


16 BEADING 7/16

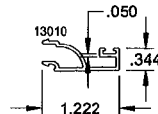


17 BEADING 9/16

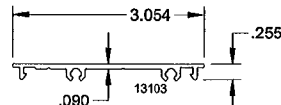


20 ANCHOR PLATE

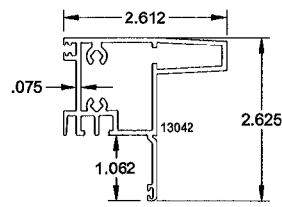

28 BOTTOM SASH
BOTTOM RAIL

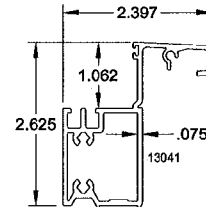

29 BOTTOM SASH
BOTTOM RAIL

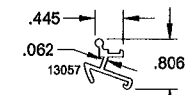

31 BOTTOM LOCK

PRODUCT REVISED
as complying with the Florida
Building Code
Acceptance No. 11-1013.17
Expiration Date Dec 6, 2012
By Mauro Garcia
Miami/Dade Product Control

ANTHONY LYNN MILLER
LICENSE
No. 58705
10/10/11
STATE OF
FLORIDA
PROFESSIONAL ENGINEER
A. LYNN MILLER, P.E.
FL P.E.# 58705


Revised By: J.R.	Date: 8/28/08	Revisions: A. Added part 17
Revised By: J.J.	Date: 10/10/11	Revisions: B NO CHANGE THIS SHEET
Revised By:	Date:	Revisions:
Drawn By: J.R.	Date: 07/12/07	Checked By: J.R. Date: 7/13/07

1070 TECHNOLOGY DRIVE
NOKOMIS, FL 34275
P.O. BOX 1528
NOKOMIS, FL 34274

PGT
Visibly Better


Description: EXTRUSIONS	Title: ALUM. SINGLE HUNG WINDOW, IMP. (SM)
Series/Model: SH3000	Scale: 1/2
Sheet: 5 of 11	Drawing No. 3000A-7-07
Rev: B	

NOTE:
FOR SMALL MISSILE APPLICATIONS ONLY

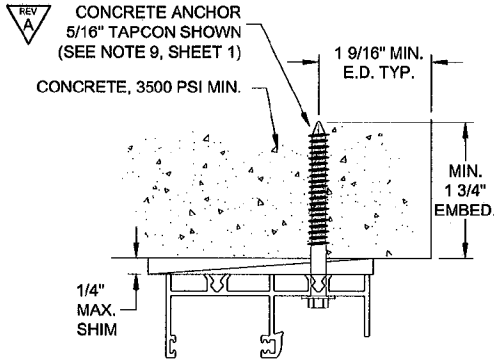


DETAIL A

CONCRETE OR CONCRETE BLOCK SUBSTRATE

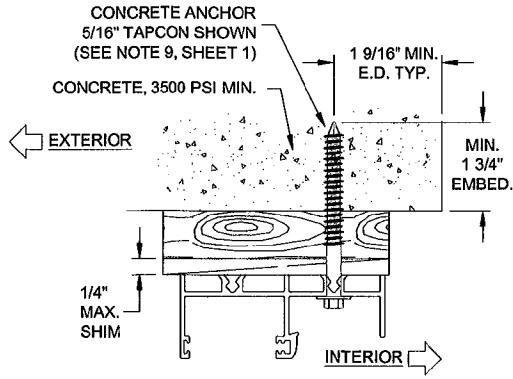

DETAIL B

CONCRETE OR CONCRETE BLOCK SUBSTRATE WITH 1X WOOD BUCK, SEE NOTE 1

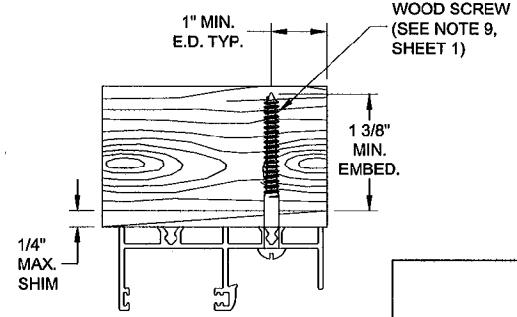

DETAIL C


2X WOOD BUCK OR DIRECTLY INTO WOOD FRAMING, SEE NOTE 1

TYPICAL HEAD ANCHORAGE

NOTES:

- WOOD BUCKS DEPICTED IN THE SECTIONS ON THIS PAGE AS 1x ARE BUCKS WHOSE TOTAL THICKNESS IS LESS THAN 1 1/2". 1x WOOD BUCKS ARE OPTIONAL IF UNIT CAN BE INSTALLED DIRECTLY TO SOLID CONCRETE. WOOD BUCKS DEPICTED AS 2x ARE 1 1/2" THICK OR GREATER. INSTALLATION TO THE SUBSTRATE OF WOOD BUCKS TO BE ENGINEERED BY OTHERS OR AS APPROVED BY AUTHORITY HAVING JURISDICTION.
- FOR ATTACHMENT TO ALUMINUM: THE MATERIAL SHALL BE A MINIMUM STRENGTH OF 6063-T5 AND A MINIMUM OF 1/8" THICK. THE ALUMINUM STRUCTURAL MEMBER SHALL BE OF A SIZE TO PROVIDE FULL SUPPORT TO THE WINDOW FRAME SIMILAR TO THAT SHOWN IN THESE DETAILS FOR 2x WOOD BUCKS. SHIMS MAY NOT BE USED. THE ANCHOR SHALL BE A #14 SHEET METAL SCREW WITH FULL ENGAGEMENT INTO THE ALUMINUM. IF THESE CRITERIA ARE MET, THE RESPECTIVE DESIGN PRESSURES, ANCHORAGE SPACING AND QUANTITIES FOR A #14 WOOD SCREW MAY BE USED.
- ANCHORS ARE NOT REQUIRED AT THE SILL.

PRODUCT REVISED as complying with the Florida Building Code
Acceptance No. 11-1013.17
Expiration Date Dec. 6, 2012
By *Mmanuel Inez*
Miami Dade Product Control

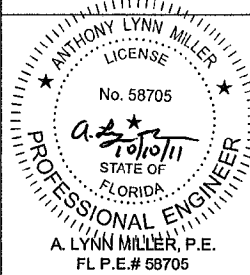

Revised By: J.R.	Date: 8/28/08	Revisions: A. Changed anchors to 5/16" Tapcon and wood screw,
Revised By:	Date:	removed CMU option from detail, moved Notes
Revised By: J.J.	Date: 10/10/11	B NO CHANGE THIS SHEET
Drawn By: J.R.	Date: 07/12/07	Checked By: J.R. Date: 7/13/07




1070 TECHNOLOGY DRIVE
NOKOMIS, FL 34275
P.O. BOX 1629
NOKOMIS, FL 34274



Description: ANCHORAGE DETAILS 1			
Title: ALUM. SINGLE HUNG WINDOW, IMP. (SM)			
Sheet Model: SH3000	Book: NTS	Sheet: 6 of 11	Drawing No: 3000A-7-07
			Rev: B



A. LYNN MILLER, P.E.
FL P.E.# 58705

REV
A

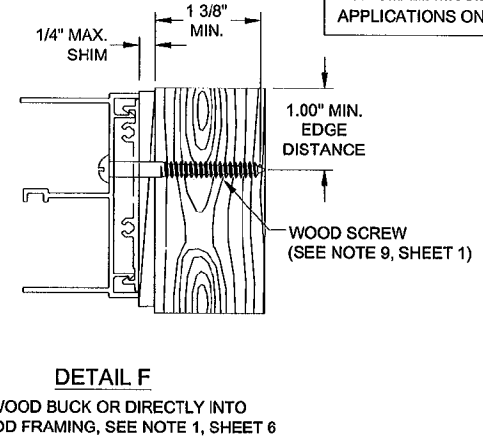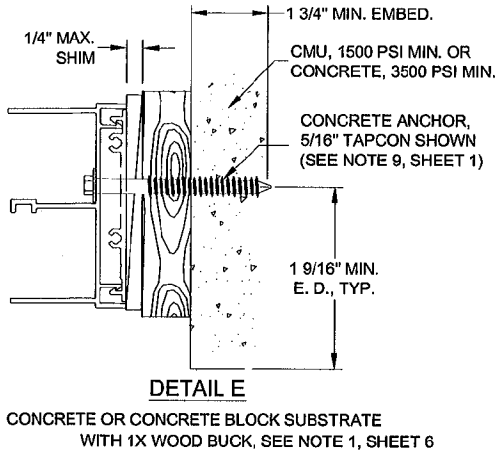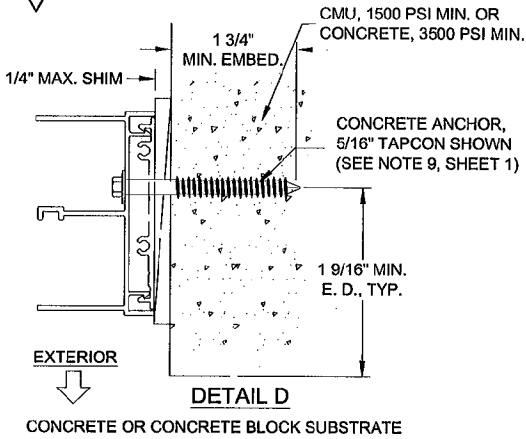

NOTE:
FOR SMALL MISSILE APPLICATIONS ONLY


TYPICAL JAMB ANCHORAGE WITH ANCHOR PLATE

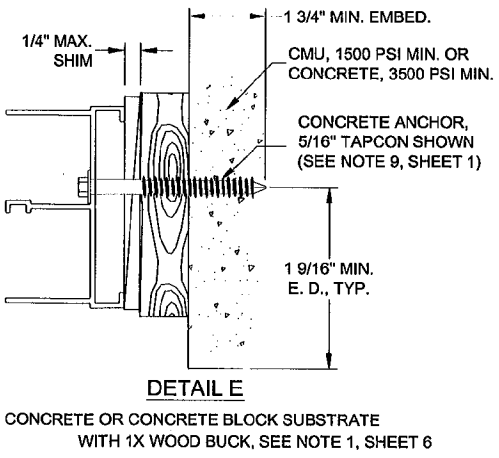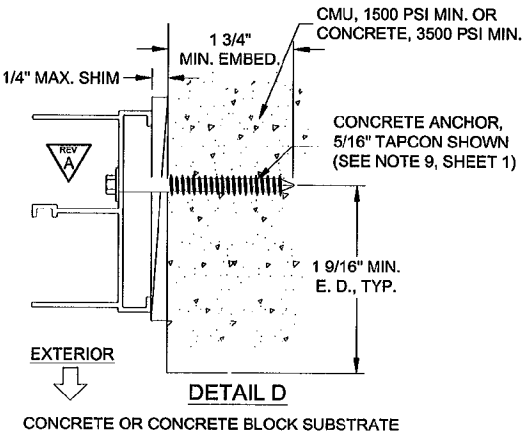

NOTE:
THE ANCHOR PLATE MUST BE USED WHEN INSTALLING INTO WOOD.

TYPICAL JAMB ANCHORAGE WITHOUT ANCHOR PLATE

PRODUCT REVISED as complying with the Florida Building Code
Acceptance No. 11-1013.17
Expiration Date Dec. 6, 2012
By *Mouad Sora*
Miami Dade Product Control

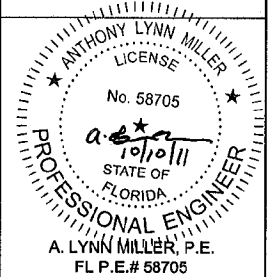

Revised By: J.R.	Date: 8/29/08	Revisions: A.	Changed anchors to 5/16" Tapcon and wood screw,
Revised By:	Date:	Revisions:	added anchor plate drawings, moved notes
Revised By: J.J.	Date: 10/10/11	Revisions: B	NO CHANGE THIS SHEET
Drawn By: J.R.	Date: 07/12/07	Checked By: J.R.	Date: 7/13/07

1070 TECHNOLOGY DRIVE
NOKOMIS, FL 34276
P.O. BOX 1829
NOKOMIS, FL 34274



Description: ANCHORAGE DETAILS 2			
Title: ALUM. SINGLE HUNG WINDOW, IMP. (SM)			
Serial/Model: SH9000	Scale: NTS	Sheet: 7 of 11	Drawn No: 3000A-7-07
Rev: B			

TABLE 3. HEAD AND JAMB ANCHOR QUANTITIES FOR DESIGN PRESSURES OF +110/-165 PSF OR LESS

NOTE:
FOR SMALL MISSILE
APPLICATIONS ONLY

WINDOW WIDTH	WINDOW HEIGHT																											
	36				48				60				72				84				96							
	1. Wood w/ Anchor Plate	2. Concrete w/o Anchor Plate	2a. Concrete w/ Anchor Plate	3. Concrete w/ Anchor Plate	1. Wood w/ Anchor Plate	2. Concrete w/o Anchor Plate	2a. Concrete w/ Anchor Plate	3. Concrete w/ Anchor Plate	1. Wood w/ Anchor Plate	2. Concrete w/o Anchor Plate	2a. Concrete w/ Anchor Plate	3. Concrete w/ Anchor Plate	1. Wood w/ Anchor Plate	2. Concrete w/o Anchor Plate	2a. Concrete w/ Anchor Plate	3. Concrete w/ Anchor Plate	1. Wood w/ Anchor Plate	2. Concrete w/o Anchor Plate	2a. Concrete w/ Anchor Plate	3. Concrete w/ Anchor Plate	1. Wood w/ Anchor Plate	2. Concrete w/o Anchor Plate	2a. Concrete w/ Anchor Plate	3. Concrete w/ Anchor Plate				
24	2	2	2	2	2	2	2	2	2	2	2	2	2	2	2	2	2	2	2	2	2	2	2	2	2	2	2	2
- 2 - 5/16" ELCO TAPCONS W/O JAMB ANCOR PLATE
- 2a - 5/16" ELCO TAPCONS & ANCHOR PLATE, ITEM 20 (FEMALE JAMB, ITEM 7)
- 3 - 1/4" ELCO TAPCONS & ANCHOR PLATE, ITEM 20 (FEMALE JAMB, ITEM 7)

2. ANCHOR LOCATIONS ARE BASED ON THE FOLLOWING TESTED DIMENSIONS AT FULL DP.


- HEAD - 4" MAX. FROM TOP CORNERS
- 16" MAX ANCHOR TO ANCHOR
- JAMBS - 5 1/2" MAX. FROM TOP/BOTTOM CORNERS
- 16" MAX ANCHOR TO ANCHOR
- 8" MAX. ABOVE/BELOW MTG. RAIL
- SILL - ANCHORS NOT REQUIRED.

TABLE KEY:

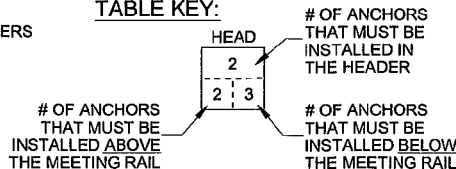

EXAMPLE:

56.125" X 91.125" WINDOW USING 5/16" WOOD ANCHORS AND ANCHOR PLATE, INTO WOOD.

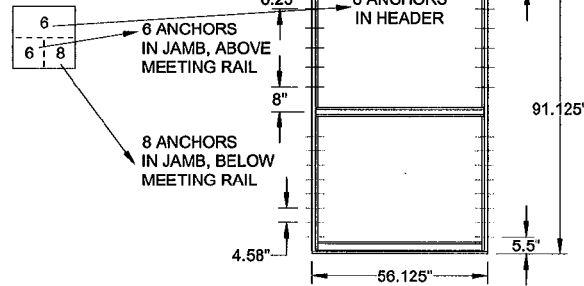


Revised By: J.R.	Date: 8/28/08	Revisions: A.	Changed table title, added example
Revised By: J.J.	Date: 10/10/11	Revisions: B.	NO CHANGE THIS SHEET
Drawn By: J.R.	Date: 07/12/07	Checked By: J.R.	Date: 7/13/07

1070 TECHNOLOGY DRIVE
NOKOMIS, FL 34275
P.O. BOX 1629
NOKOMIS, FL 34274



Description: ANCHORAGE QUANTITIES	Series/Model: SH3000	Scale: NTS	Sheet: 8 of 11	Drawing No: 3000A-7-07	Rev: B
Title: ALUM. SINGLE HUNG WINDOW, IMP. (SM)					

PRODUCT REVISED as complying with the Florida Building Code
Acceptance No. 11-1013-17
Expiration Date Dec 6, 2012
By: *Manuel Miller*
Miami Dade Product Control

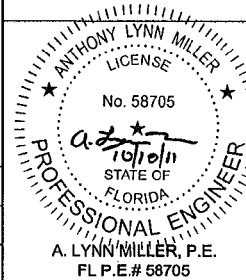

A. LYNN MILLER, P.E.
FL P.E.# 58705

NOTE:
FOR SMALL MISSILE
APPLICATIONS ONLY

TABLE 4. HEAD AND JAMB ANCHOR QUANTITIES FOR DESIGN PRESSURES OF +110/-150 PSF OR LESS

WINDOW WIDTH	WINDOW HEIGHT																									
	36				48				60				72				84				96					
	1, Wood w/ Anchor Plate	2, Concrete w/o Anchor Plate	2a, Concrete w/ Anchor Plate	3, Concrete w/ Anchor Plate	1, Wood w/ Anchor Plate	2, Concrete w/o Anchor Plate	2a, Concrete w/ Anchor Plate	3, Concrete w/ Anchor Plate	1, Wood w/ Anchor Plate	2, Concrete w/o Anchor Plate	2a, Concrete w/ Anchor Plate	3, Concrete w/ Anchor Plate	1, Wood w/ Anchor Plate	2, Concrete w/o Anchor Plate	2a, Concrete w/ Anchor Plate	3, Concrete w/ Anchor Plate	1, Wood w/ Anchor Plate	2, Concrete w/o Anchor Plate	2a, Concrete w/ Anchor Plate	3, Concrete w/ Anchor Plate	1, Wood w/ Anchor Plate	2, Concrete w/o Anchor Plate	2a, Concrete w/ Anchor Plate	3, Concrete w/ Anchor Plate		
24	2	2	2	2	2	2	2	2	2	2	2	2	2	2	2	2	2	2	2	2	2	2	2	2	2	2
30	3	3	3	3	3	3	3	3	3	3	3	3	3	3	3	3	3	3	3	3	3	3	3	3	3	3
36	3	3	3	3	3	3	3	4	3	3	3	4	3	4	3	3	4	3	3	3	4	3	3	4	3	4
42	4	4	4	4	4	4	4	5	4	4	4	5	4	4	4	5	4	4	4	5	4	4	4	6	4	6
48	4	4	4	4	4	4	4	5	4	4	4	6	4	4	4	7	4	4	4	7	4	4	4	8	4	7
54	4	4	4	5	4	4	4	6	4	4	4	7	4	4	4	8	5	4	4	9	5	4	4	10	5	7
60	4	4	4	5	4	4	4	7	4	4	4	8	5	4	4	9	5	5	5	10	5	5	5	11	5	10

ANCHORAGE NOTES:

1. ANCHOR TYPES:




- 1 - #14 WOOD SCREW, STEEL (G5) & ANCHOR PLATE, ITEM 20 (FEMALE JAMB, ITEM 7)
- 2 - 5/16" ELCO TAPCONS W/O JAMB ANCOR PLATE
- 2a - 5/16" ELCO TAPCONS & ANCHOR PLATE, ITEM 20 (FEMALE JAMB, ITEM 7)
- 3 - 1/4" ELCO TAPCONS & ANCHOR PLATE, ITEM 20 (FEMALE JAMB, ITEM 7)

2. ANCHOR LOCATIONS ARE BASED ON THE FOLLOWING TESTED DIMENSIONS AT FULL DP.

- HEAD - 4" MAX. FROM TOP CORNERS
- 16" MAX ANCHOR TO ANCHOR
- JAMBS - 5 1/2" MAX. FROM TOP/BOTTOM CORNERS
- 16" MAX ANCHOR TO ANCHOR
- 8" MAX. ABOVE/BELOW MTG. RAIL
- SILL - ANCHORS NOT REQUIRED.

TABLE KEY:

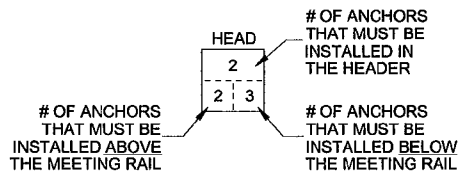


Revised By: J.R.	Date: 8/28/08	Revisions: A. Changed table title, added example
Revised By: J.J.	Date: 10/10/11	Revisions: B NO CHANGE THIS SHEET
Revised By:	Date:	Revisions:
Drawn By: J.R.	Date: 07/12/07	Checked By: J.R. Date: 7/13/07

1070 TECHNOLOGY DRIVE
NOKOMIS, FL 34276
P.O. BOX 1529
NOKOMIS, FL 34274



Description: ANCHORAGE DESIGN PRESSURE			
Title: ALUM. SINGLE HUNG WINDOW, IMP. (SM)			
Series/Model: SH3000	Scale: NTS	Sheet: 9 of 11	Drawing No: 3000A-7-07
Rev: B			

PRODUCT REVISED as complying with the Florida Building Code Acceptance No. 11-1013-17 Expiration Date DEC 6, 2012
By: *Maurice Serr*
Miami/Dade Product Control

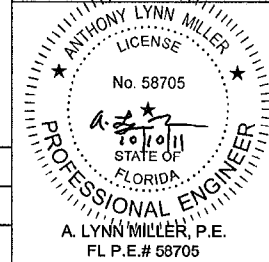

A. LYNN MILLER, P.E.
FL P.E.# 58705

NOTE:
FOR SMALL MISSILE
APPLICATIONS ONLY

TABLE 5. HEAD AND JAMB ANCHOR QUANTITIES FOR DESIGN PRESSURES OF +110/-135 PSF OR LESS

WINDOW WIDTH	WINDOW HEIGHT																							
	36				48				60				72				84				96			
	1, Wood w/ Anchor Plate	2, Concrete w/o Anchor Plate	2a, Concrete w/ Anchor Plate	3, Concrete w/ Anchor Plate	1, Wood w/ Anchor Plate	2, Concrete w/o Anchor Plate	2a, Concrete w/ Anchor Plate	3, Concrete w/ Anchor Plate	1, Wood w/ Anchor Plate	2, Concrete w/o Anchor Plate	2a, Concrete w/ Anchor Plate	3, Concrete w/ Anchor Plate	1, Wood w/ Anchor Plate	2, Concrete w/o Anchor Plate	2a, Concrete w/ Anchor Plate	3, Concrete w/ Anchor Plate	1, Wood w/ Anchor Plate	2, Concrete w/o Anchor Plate	2a, Concrete w/ Anchor Plate	3, Concrete w/ Anchor Plate	1, Wood w/ Anchor Plate	2, Concrete w/o Anchor Plate	2a, Concrete w/ Anchor Plate	3, Concrete w/ Anchor Plate
24	2	2	2	2	2	2	2	2	2	2	2	2	2	2	2	2	2	2	2	2	2	2	2	2
	2	2	2	2	2	2	2	2	2	2	2	2	2	2	2	2	2	2	2	2	2	2	2	2
30	3	3	3	3	3	3	3	3	3	3	3	3	3	3	3	3	3	3	3	3	3	3	3	3
	2	2	2	2	2	2	2	2	2	2	2	2	2	2	2	2	2	2	2	2	2	2	2	2
36	3	3	3	3	3	3	3	3	3	3	3	3	3	3	3	3	3	3	3	3	3	3	3	3
	2	2	2	2	2	2	2	2	2	2	2	2	2	2	2	2	2	2	2	2	2	2	2	2
42	4	4	4	4	4	4	4	4	4	4	4	4	4	4	4	4	4	4	4	4	4	4	4	4
	2	2	2	2	2	2	2	2	2	2	2	2	2	2	2	2	2	2	2	2	2	2	2	2
48	4	4	4	4	4	4	4	4	4	4	4	4	4	4	4	4	4	4	4	4	4	4	4	4
	2	2	2	2	2	2	2	2	2	2	2	2	2	2	2	2	2	2	2	2	2	2	2	2
54	4	4	4	5	4	4	4	6	4	4	4	7	4	4	4	7	4	4	4	8	4	4	4	8
	2	3	2	2	2	3	3	5	2	3	2	3	3	4	4	6	3	4	3	4	3	5	7	5
56	4	4	4	5	4	4	4	6	4	4	4	7	4	4	4	8	5	4	4	8	5	4	4	9
	2	3	2	2	2	3	3	5	2	4	2	4	3	4	4	6	3	4	3	4	3	5	8	5

ANCHORAGE NOTES:


1. ANCHOR TYPES:

- 1 - #14 WOOD SCREW, STEEL (G5) & ANCHOR PLATE, ITEM 20 (FEMALE JAMB, ITEM 7)
- 2 - 5/16" ELCO TAPCONS W/O JAMB ANCHOR PLATE
- 2a - 5/16" ELCO TAPCONS & ANCHOR PLATE, ITEM 20 (FEMALE JAMB, ITEM 7)
- 3 - 1/4" ELCO TAPCONS & ANCHOR PLATE, ITEM 20 (FEMALE JAMB, ITEM 7)

2. ANCHOR LOCATIONS ARE BASED ON THE FOLLOWING TESTED DIMENSIONS AT FULL DP.

- HEAD - 4" MAX. FROM TOP CORNERS
- 16" MAX ANCHOR TO ANCHOR
- JAMBS - 5 1/2" MAX. FROM TOP/BOTTOM CORNERS
- 16" MAX ANCHOR TO ANCHOR
- 8" MAX. ABOVE/BELOW MTG. RAIL
- SILL - ANCHORS NOT REQUIRED.

TABLE KEY:

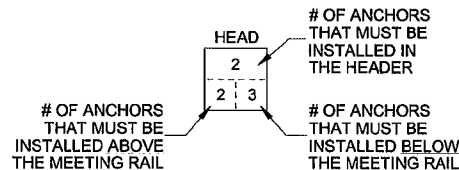


Revised By: J.R.	Date: 8/28/08	Revisions: A. Changed table title, added example
Revised By: J.J.	Date: 10/10/11	Revisions: B. NO CHANGE THIS SHEET
Drawn By: J.R.	Date: 07/12/07	Checked By: J.R. Date: 7/13/07

1070 TECHNOLOGY DRIVE
NOKOMIS, FL 34276
P.O. BOX 1529
NOKOMIS, FL 34274



Description: ANCHORAGE 1/4"
Title: ALUM. SINGLE HUNG WINDOW, IMP. (SM)
Series/Model: SH3000 Scale: NTS Sheet: 10 of 11 Drawing No: 3000A-7-07 Rev: B

PRODUCT REVISED as complying with the Florida Building Code
Acceptance No. 11-1013-17
Expiration Date Dec 6, 2012
By: *Manuel Perez*
Miami Dade Product Control

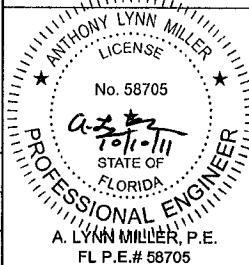

NOTE:
FOR SMALL MISSILE
APPLICATIONS ONLY

EGRESS OPENINGS FOR 1/1 WINDOWS

TABLE 6.

		WINDOW HEIGHT												
		68	70	72	74	76	78	80	82	84	86	88	90	92
WINDOW WIDTH	24.625													
	26													
	28													
	30													
	32													
	34													
	36													
	38													
	40 & Greater													

Meets Egress for 5.0 ft²

Meets Egress for 5.7 ft²

EGRESS NOTES:

FLORIDA BUILDING CODE, REQUIRES 20" IN WIDTH, 24" IN HEIGHT, AND 5.7 SQUARE FEET OF CLEAR OPENING (5.0 SQUARE FEET ON GROUND FLOOR), TO MEET EGRESS REQUIREMENTS.



Revised By: J.R.	Date: 8/28/08	Revisions: A.	A. Specified FBC year
Revised By: J.J.	Date: 10/10/11	Revisions: B	REMOVED FBC YEAR
Revised By:	Date:	Revisions:	
Drawn By: J.R.	Date: 07/12/07	Checked By: J.R.	Date: 7/13/07

1070 TECHNOLOGY DRIVE
NOKOMIS, FL 34276
P.O. BOX 1529
NOKOMIS, FL 34274



Description: EGRESS CHART			
Title: ALUM. SINGLE HUNG WINDOW, IMP. (SM)			
Series/Model: SH3000	Scale: NTS	Sheet: 11 of 11	Drawing No: 3000A-7-07
			Rev: B

PRODUCT REVISED
as complying with the Florida
Building Code
Acceptance No. 11-1013.17
Expiration Date Dec 14, 2012
By *Maurick*
Miami Dade Product Control

